

8/013/0011  
 TASK 8162  
 ce Leslie  
 0003

Form MR-REV-SMO (DOGM - Revise/Amend Change Form)  
 (Revised November 21, 2006)

## Application to Revise a Notice of Intention to Commence Small Mining Operations or Exploration

<b>Operator:</b>			
<b>Mine Name:</b> Castle Peak		<b>File Number: E or M/</b> 8/013/0011	
Provide a detailed listing of all changes to the Notice that will be required as a result of this change. Individually list all maps and drawings that are to be added, replaced, or removed from the Notice. Include page, section and drawing numbers as part of the description.			
DETAILED SCHEDULE OF CHANGES TO THE NOTICE			
			Description of map, text, or materials to be changed
ADD	REPLACE	REMOVE	Page 1
ADD	REPLACE	REMOVE	Page 2
ADD	REPLACE	REMOVE	Page 4
ADD	REPLACE	REMOVE	Map 5
ADD	REPLACE	REMOVE	Map 6
ADD	REPLACE	REMOVE	

I hereby certify that I am a responsible official of the applicant and that the information contained in this application is true and correct to the best of my information and belief in all respects with the laws of Utah in reference to commitments and obligations, herein.

Marc Nelson  
 Print Name

[Signature] managing member  
 Sign Name, Position

9/17/09  
 Date

**Return to:**  
 State of Utah  
 Division of Oil, Gas and Mining  
 Attn: Minerals Regulatory Program  
 1594 West North Temple, Suite 1210  
 Box 145801  
 Salt Lake City, Utah 84114-5801  
 Phone: (801) 538-5291 Fax: (801) 359-3940  
 P:\GROUPS\MINERALS\WP\FORMS\notices\Final\revision\_SMO\_EXP.doc

<b>FOR DOGM USE ONLY:</b>
File #: <u>M/</u> / <u>1</u>
Approved: _____
Bond Adjustment: from (\$) _____
to \$ _____

RECEIVED

SEP 17 2009

DIV. OF OIL, GAS & MINING

0003

## Application to Revise a Notice of Intention to Commence Small Mining Operations or Exploration

Operator: <u>Lance Conn LLC - Castle Peak LLC</u>			
Mine Name: <u>Castle Peak</u>		File Number: <u>E or M/ 1</u>	
Provide a detailed listing of all changes to the Notice that will be required as a result of this change. Individually list all maps and drawings that are to be added, replaced, or removed from the Notice. Include page, section and drawing numbers as part of the description.			
DETAILED SCHEDULE OF CHANGES TO THE NOTICE			
			Description of map, text, or materials to be changed
ADD	<u>REPLACE</u>	REMOVE	mill site sec 32 T45R7E S21M mill site
<u>ADD</u>	REPLACE	REMOVE	sample 300' Reserve Pit 50' deep
<u>ADD</u>	REPLACE	REMOVE	sec 36 T45R1E DISTURBANCES 4000
ADD	<u>REPLACE</u>	REMOVE	Drill holes to 50' sec 32 T45R1E S21M
ADD	<u>REPLACE</u>	REMOVE	ASMA LLC & Lance Conn LLC By <del>Castle Peak</del>
ADD	REPLACE	REMOVE	<u>Peak LLC</u>
ADD	REPLACE	REMOVE	

I hereby certify that I am a responsible official of the applicant and that the information contained in this application is true and correct to the best of my information and belief in all respects with the laws of Utah in reference to commitments and obligations, herein.

Lance Conn  
 Print Name

Lance Conn Operator  
 Sign Name, Position

9 9 09  
 Date

**Return to:**  
 State of Utah  
 Division of Oil, Gas and Mining  
 Attn: Minerals Regulatory Program  
 1594 West North Temple, Suite 1210  
 Box 145801  
 Salt Lake City, Utah 84114-5801  
 Phone: (801) 538-5291 Fax: (801) 359-3940

<b>FOR DOGM USE ONLY:</b>
File #: <u>M/ 1</u>
Approved: _____
Bond Adjustment: from (\$) _____
to \$ _____

RECEIVED

SEP 17 2009

DIV. OF OIL, GAS & MINING

**STATE OF UTAH**  
**DEPARTMENT OF NATURAL RESOURCES**  
**DIVISION OF OIL, GAS AND MINING**  
1594 West North Temple Suite 1210  
Box 145801  
Salt Lake City, Utah 84114-5801  
Telephone: (801) 538-5291 Fax: (801) 359-3940

**NOTICE OF INTENTION TO COMMENCE SMALL MINING OPERATIONS**

The informational requirements of this form are based on provisions of the Mined Land Reclamation Act, Title 40-8, Utah Code Annotated 1987, and the General Rules as promulgated under the Utah Minerals Regulatory Program.

"Small Mining Operations" mining operations which have a disturbed area of five or less surface acres at any time.

\*\*\*\*\*

**I. GENERAL INFORMATION** (Rule R647-3-104)

1. Name of Mine: Castle Peak S0130011

2. Legal name of entity (or individual) for whom the permit is being requested: \_\_\_\_\_

Castle Peak Exploration LLC  
Mailing Address: 523 E. Harvest Moon Drive  
City, State, Zip: Pleasant Grove Utah 84062  
Phone: 801-921-3228 Fax: 801-772-2772  
E-mail Address: Marc@Inlineassets.com

Type of Business: Corporation ( ) LLC  Sole Proprietorship (dba) ( )  
Partnership ( ) General \_\_\_\_\_ or \_\_\_\_\_ limited  
Or:  
Individual ( )

Entity must be registered (and maintain registration) with the State of Utah, Division of Corporations (DOC) [www.commerce.utah.gov](http://www.commerce.utah.gov).

Are you currently registered to do business in the State of Utah?  Yes  No

Entity # 27-0924062

If no, contact [www.commerce.utah.gov](http://www.commerce.utah.gov) to renew or apply.

Local Business License # \_\_\_\_\_ (if required)  
Issued by: County \_\_\_\_\_ or City \_\_\_\_\_

3. **Contact Person(s)**  
Name: Marc Nelson Title: Manager  
Address: 523 E. Harvest Moon Drive  
City, State, Zip: Pleasant Grove Utah 84062  
Phone: 801-921-3228 Fax: 801-772-2772  
Emergency, Weekend, or Holiday Phone: \_\_\_\_\_  
E-mail Address: Marc@inlineassets.com

Contact person to be notified for: permitting  surety  Notices  (please check all that apply)

RECEIVED

SEP 17 2009

Name: Terry Lance Title: \_\_\_\_\_  
Address: 185 West 300 South  
City, State, Zip: Duchesne Utah 84021  
Phone: 435-738-5932 Fax: \_\_\_\_\_  
Emergency, Weekend, or Holiday Phone: \_\_\_\_\_  
E-mail Address: \_\_\_\_\_

Contact person to be notified for: permitting  surety  Notices  (please check all that apply)

Registered Utah Agent (as identified with the Utah Department of Commerce) (if individual leave blank):

Name: \_\_\_\_\_  
Address: \_\_\_\_\_  
City, State, Zip: \_\_\_\_\_  
Phone: \_\_\_\_\_ Fax: \_\_\_\_\_  
E-mail Address: \_\_\_\_\_

4. **If Business is a Sole Proprietor:**

Name of Owner: \_\_\_\_\_ Title: \_\_\_\_\_  
Business Address: \_\_\_\_\_  
City, State, Zip: \_\_\_\_\_  
Phone: \_\_\_\_\_ Fax: \_\_\_\_\_  
E-mail Address: \_\_\_\_\_

**If Business is a Corporation:**

Name of Officers: \_\_\_\_\_ Title: \_\_\_\_\_  
\_\_\_\_\_ Title: \_\_\_\_\_  
\_\_\_\_\_ Title: \_\_\_\_\_  
\_\_\_\_\_ Title: \_\_\_\_\_

Headquarters Address: \_\_\_\_\_  
City, State, Zip: \_\_\_\_\_  
Headquarters Phone: \_\_\_\_\_ Fax: \_\_\_\_\_  
E-mail Address: \_\_\_\_\_

**If Business is a Limited Liability Company:** Member Managed  Manager Managed

Name of 1<sup>st</sup> Member/Manager: Marc Nelson Title: Manager  
Business Address: 523 E. Harvest Moon Drive  
City, State, Zip: Pleasant Grove Utah 84062  
Phone: 801-921-3228 Fax: 801-772-2772  
E-mail Address: Marc @ Inlineassets.com

Name of 2<sup>nd</sup> Member/Manager: G. R. Cann  
Business Address: ~~4350 Alameda Drive~~ P.O. Box 929  
City, State, Zip: Duchesne Utah 84021  
Phone: 435-733-0308 Fax: \_\_\_\_\_  
E-mail Address: \_\_\_\_\_

**If Business is a Partnership:**

Name of Partner: \_\_\_\_\_  
Business Address: \_\_\_\_\_  
City, State, Zip: \_\_\_\_\_  
Phone: \_\_\_\_\_ Fax: \_\_\_\_\_  
E-mail Address: \_\_\_\_\_

II. **PROJECT LOCATION & MAP** (Rule R647-3-105)

1. **Project Location** (legal description):

County(ies): \_\_\_\_\_

\_\_\_\_\_ 1/4, of \_\_\_\_\_ 1/4, of SE 1/4: Section: 32 Township: 8S Range: 17E. mill site  
SW 1/4, of NE 1/4, of NE 1/4: Section: 2 Township: 9S Range: 17E. mine site  
\_\_\_\_\_ 1/4, of \_\_\_\_\_ 1/4, of SW 1/4: Section: 36 Township: 8S Range: 16E. mine site

UTM East \_\_\_\_\_ (if known) UTM North \_\_\_\_\_ (if known)

Name of Quad Map for Location: Myton SE

2. **Location and Operations maps** must be plotted at a scale to accurately identify locational landmarks and operations details. All maps must include a north arrow, scale, appropriate labels, and title box including the mine name, township, range and section.

a. The **general location map** must be the scale of a USGS 7.5 minute series map or equivalent (1"=2000') and identify new or existing access roads.

b. The **operations map** (1"=200' or other scale as determined necessary by the Division) must be labeled and identify:

- i. The area to be disturbed;
- ii. The location of any existing or proposed operations including access roads, drill holes, trenches, pits, shafts, cuts, or other planned activities; and
- iii. Any adjacent previous disturbance for which the operator is not responsible.

(Contact the Division for a list of consultants and land surveyors for mapping assistance.)

3. The proposed (5 acre or less) disturbed area (including access/haul roads) should be marked in the field ON THE GROUND with metal T-Posts (or with some other marker of equal effectiveness). Markers should be appropriately spaced so that the next marker in either direction is clearly visible with the naked eye.

III. **OPERATION PLAN** (Rule R647-3-106)


1. **Type of mining:**  Surface  Underground

2. **Mineral(s) to be mined:** Copper, Molybdenum, Silver, Gold, Uranium

3. **Amount of material** to be extracted, moved, or proposed to be moved: \_\_\_\_\_  
Sec 32 > 1000 tons, Sec 2 < 1000 tons, Sec 36 < 1000 tons

4. Will any **water, liquid chemicals, reagents, or other solutions** be used, produced or discharged as part of the mining or milling process?  
Yes  No  If yes, please describe (add extra pages if needed) \_\_\_\_\_  
\_\_\_\_\_  
\_\_\_\_\_


5. Provide a brief **description of the proposed mining operation** and onsite processing facilities (add extra pages if necessary). \_\_\_\_\_  
\_\_\_\_\_  
\_\_\_\_\_

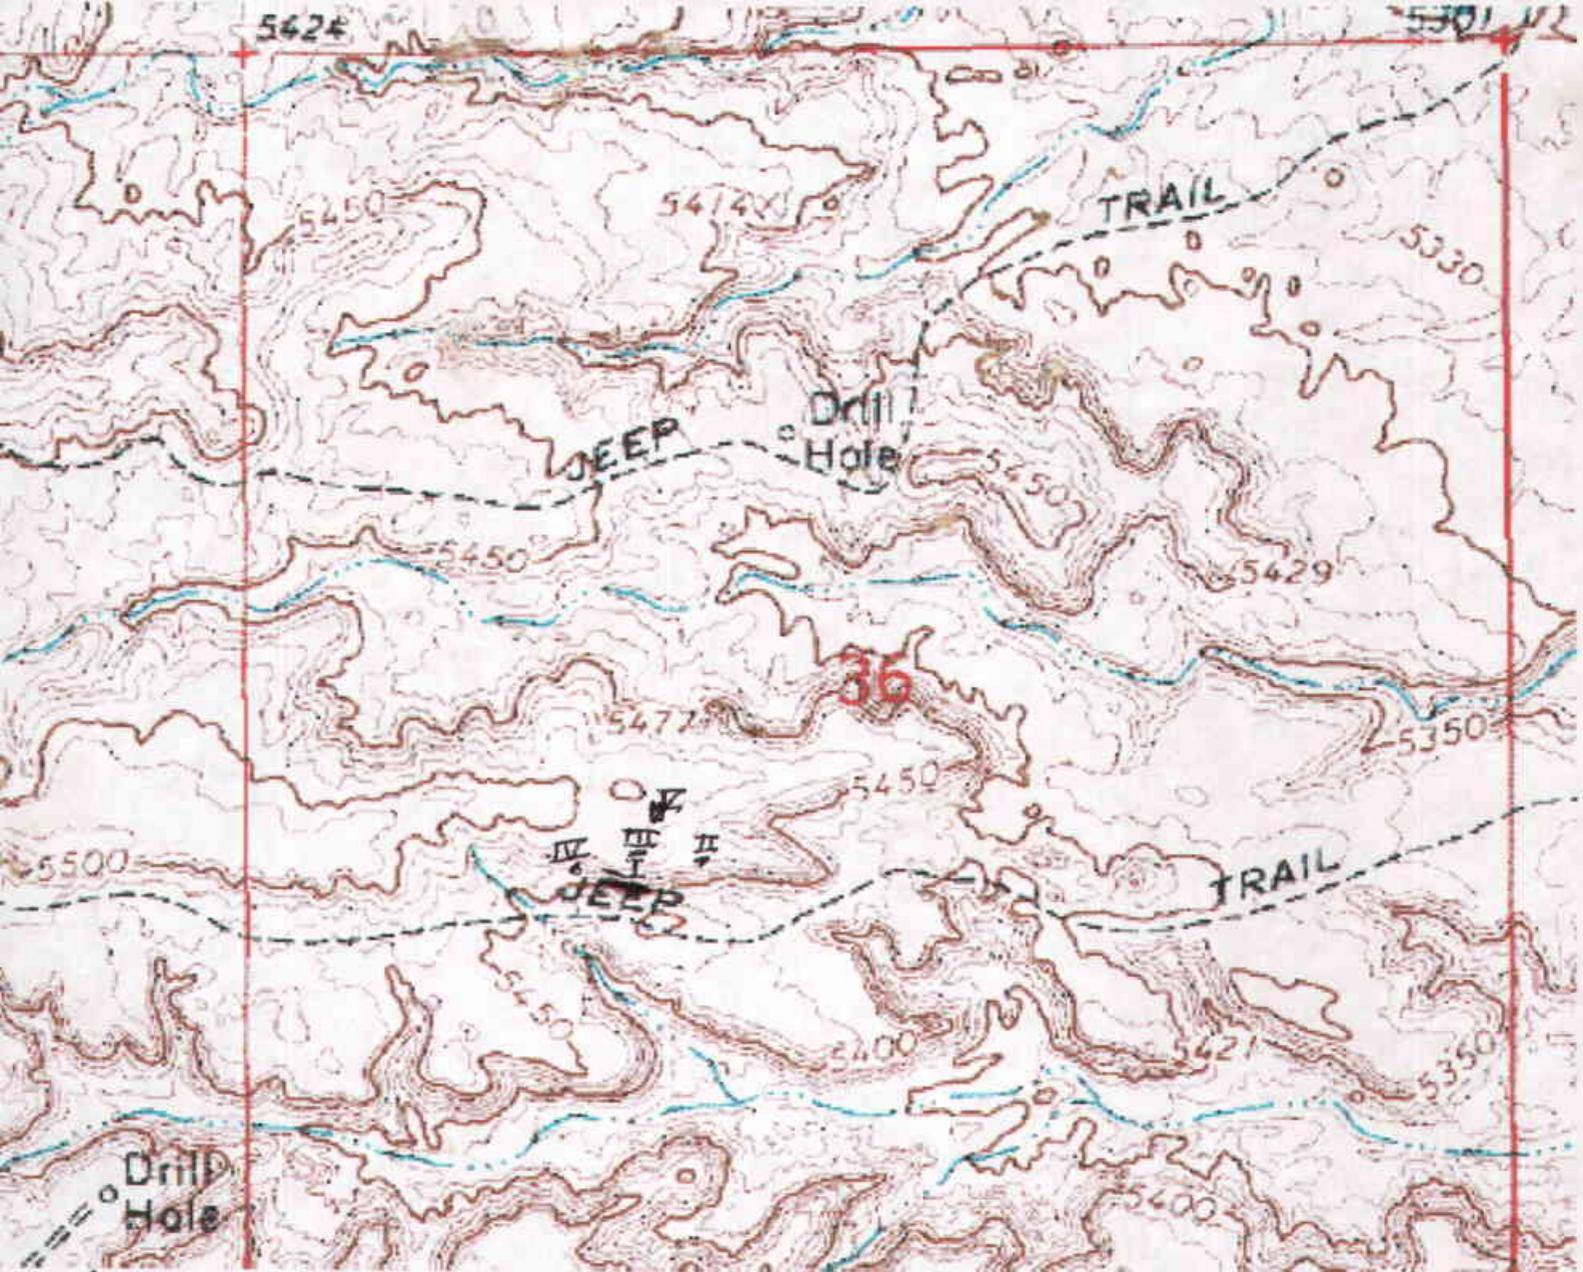

Sec 36 T8S R16E  
 1 inch = 797 feet

- I 90' x 9'
- II 21' x 9'
- III 30' x 15'
- IV 15' x 13'
- V 147' x 123'

1464 square feet of disturbance on South End  
 14,000 square feet of disturbance on North End  
 17 truck load of ore were taken to Sec 32  
 and stockpiled. Approximately 17 tons  
 no ore was removed, crossed assay reports. Topsoil was  
 piled underlying rock was piled on site. When wire  
 supplied us to the ~~error~~ this site was pushed  
 back in and covered with topsoil

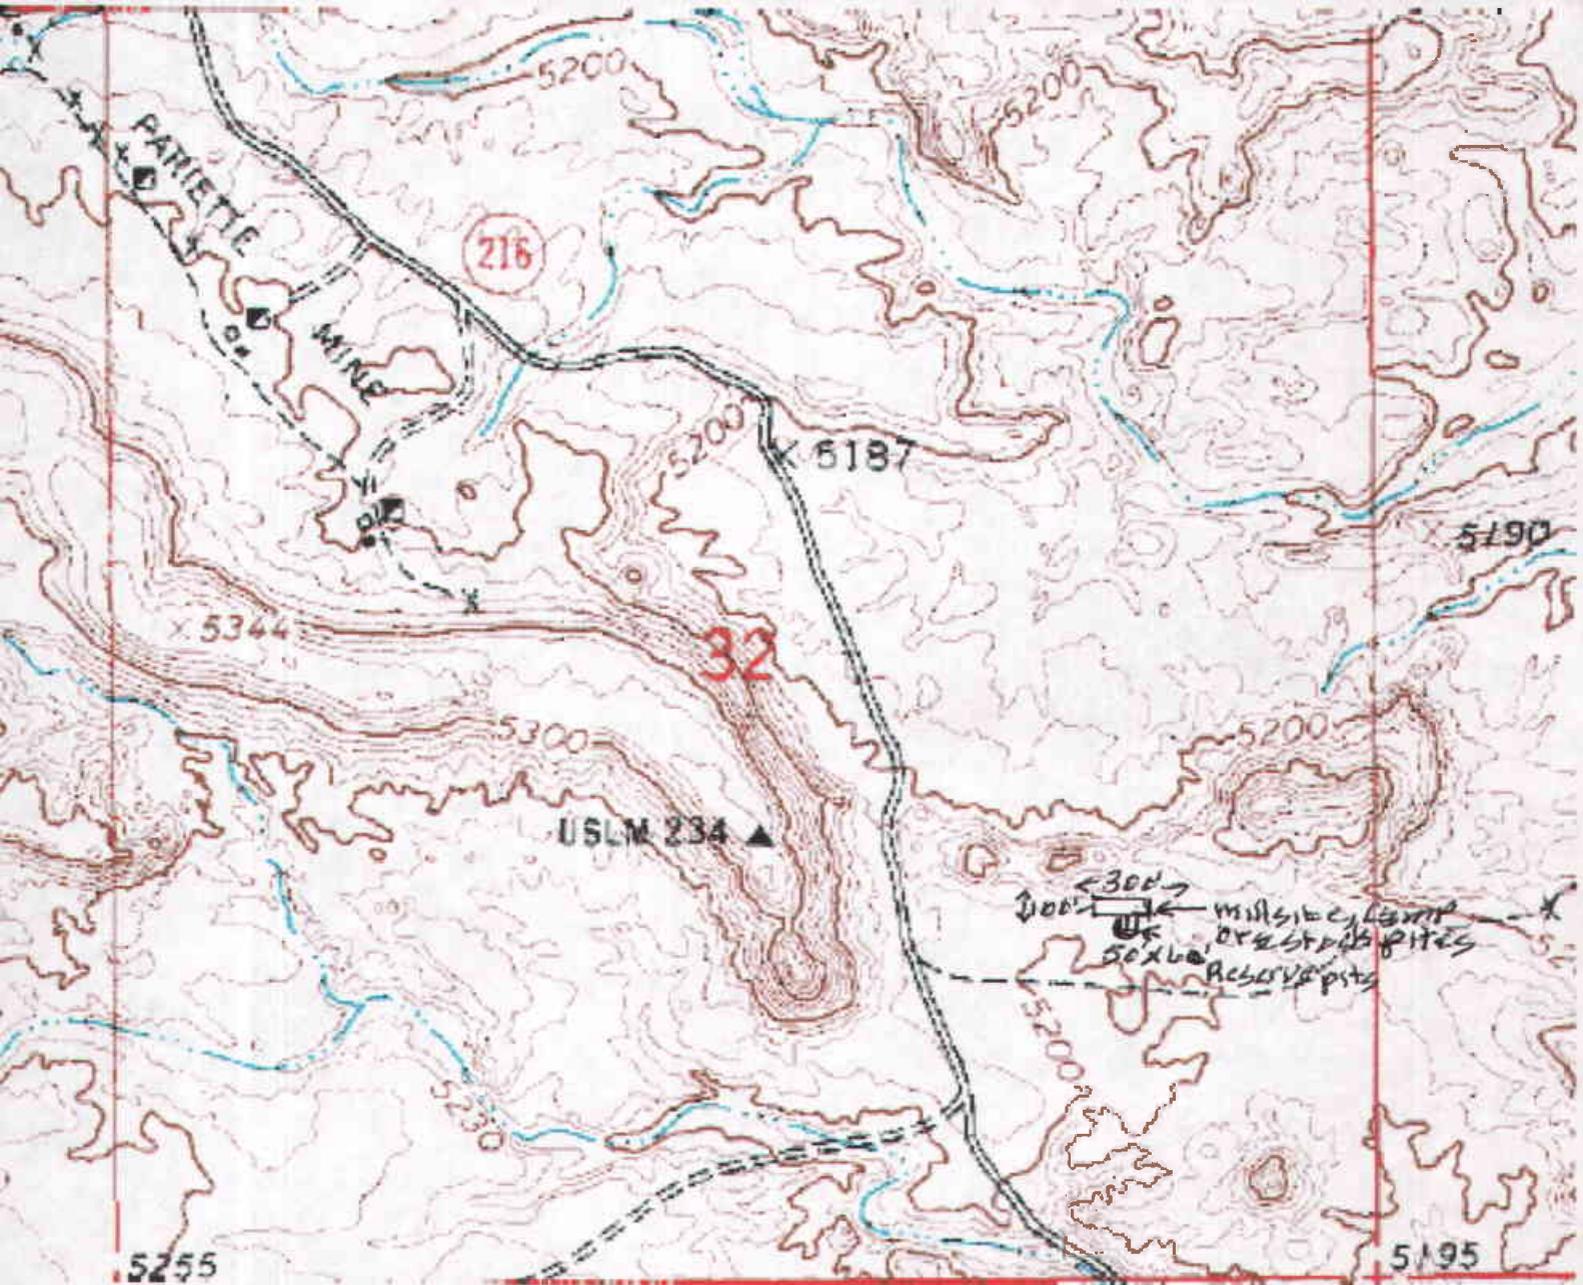

Camp, ore stockpiles, missile & reserve pits were placed in an area with little to no vegetation and relatively flat. Milk site, ore stockpiles, camp & pits encompass about 33,000 square ft. Reserve pits (water) were formed on red clay & lined with plastic liner and hold approximately 650 BBL's water